


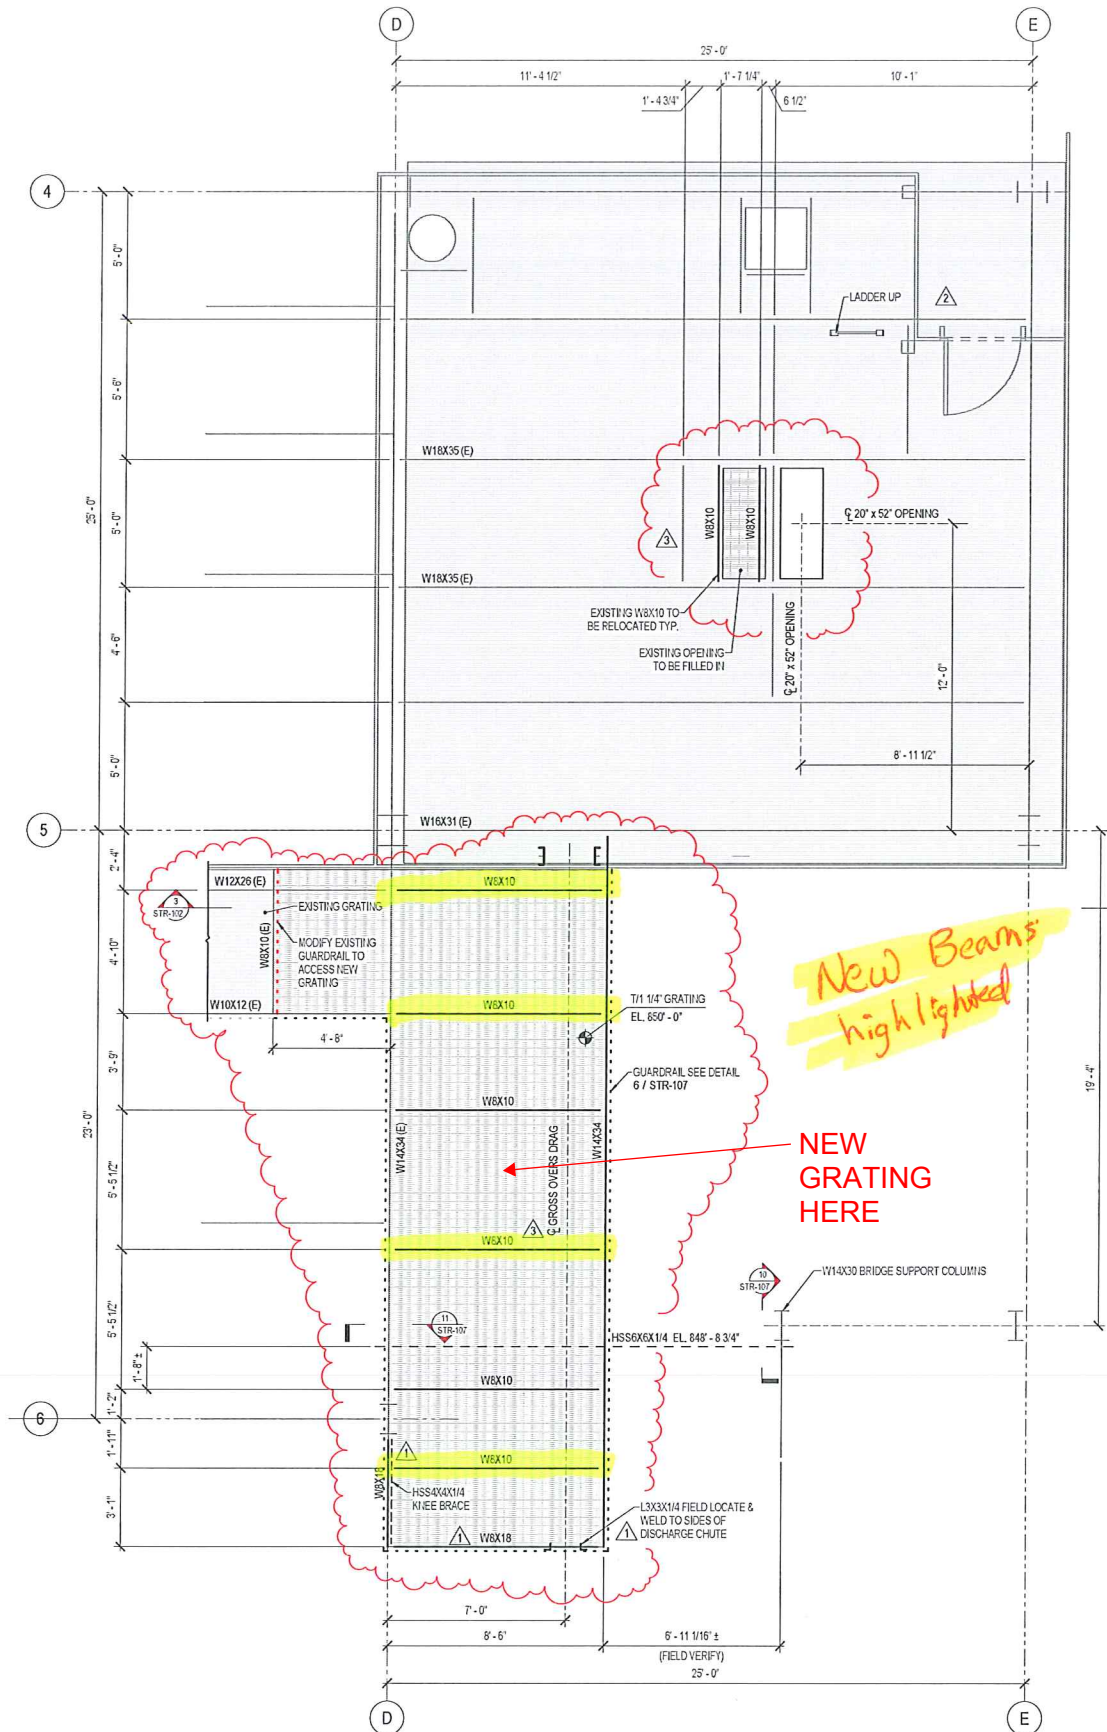

1 2nd FLOOR T/STL. 849' - 10 3/4"

3	AS-BUILT REVISIONS	9/24/18
2	MODIFIED PLATFORM	6/25/18
1	DOOR RELOCATION & CHUTE SUPPORT	6/11/18
0	ISSUED FOR CONSTRUCTION	05/07/18
NO.	REVISION	DATE

Shoemaker
Haaland
www.shoemaker-haaland.com




PROJECT:
SEED CLEANING MODIFICATIONS

SHEET TITLE:
T/STL. 849' - 6" & 857' - 10 1/2"

PROJECT NUMBER:
18022
ISSUED DATE: 03/08/18
DRAWN BY: JRC
CHECKED BY: SME
APPROVED BY: SME

SHEET NUMBER:
STR-102

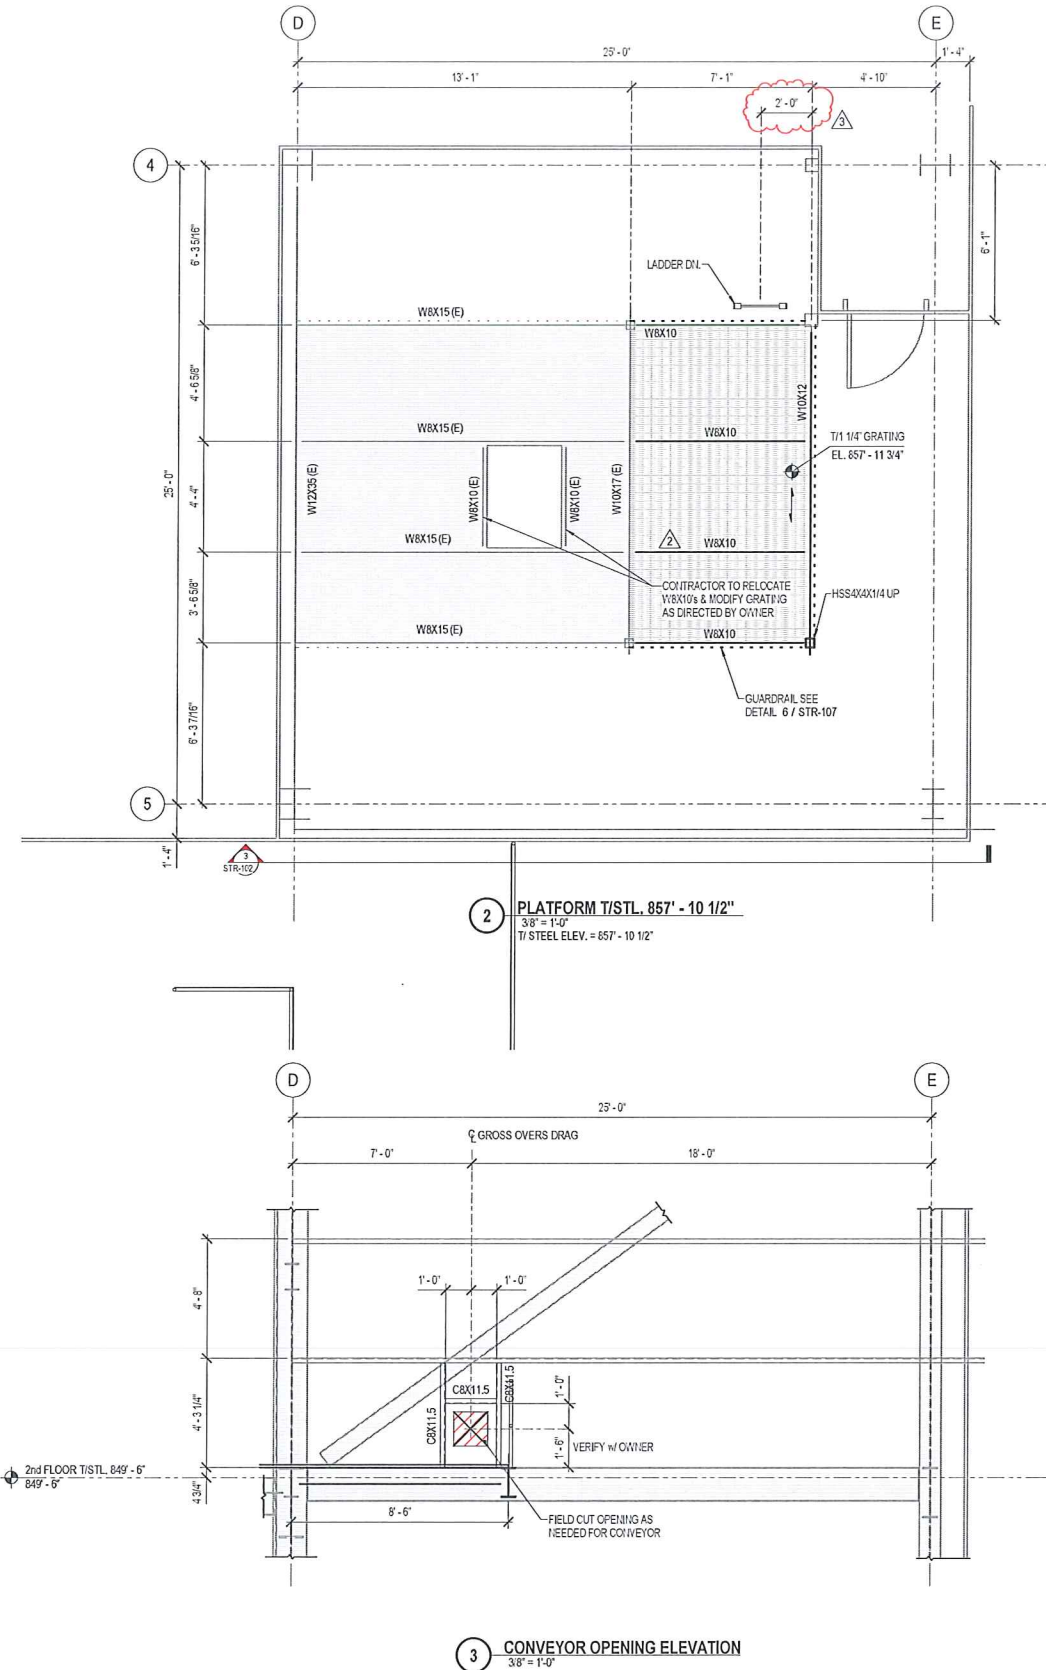

3 CONVEYOR OPENING ELEVATION